
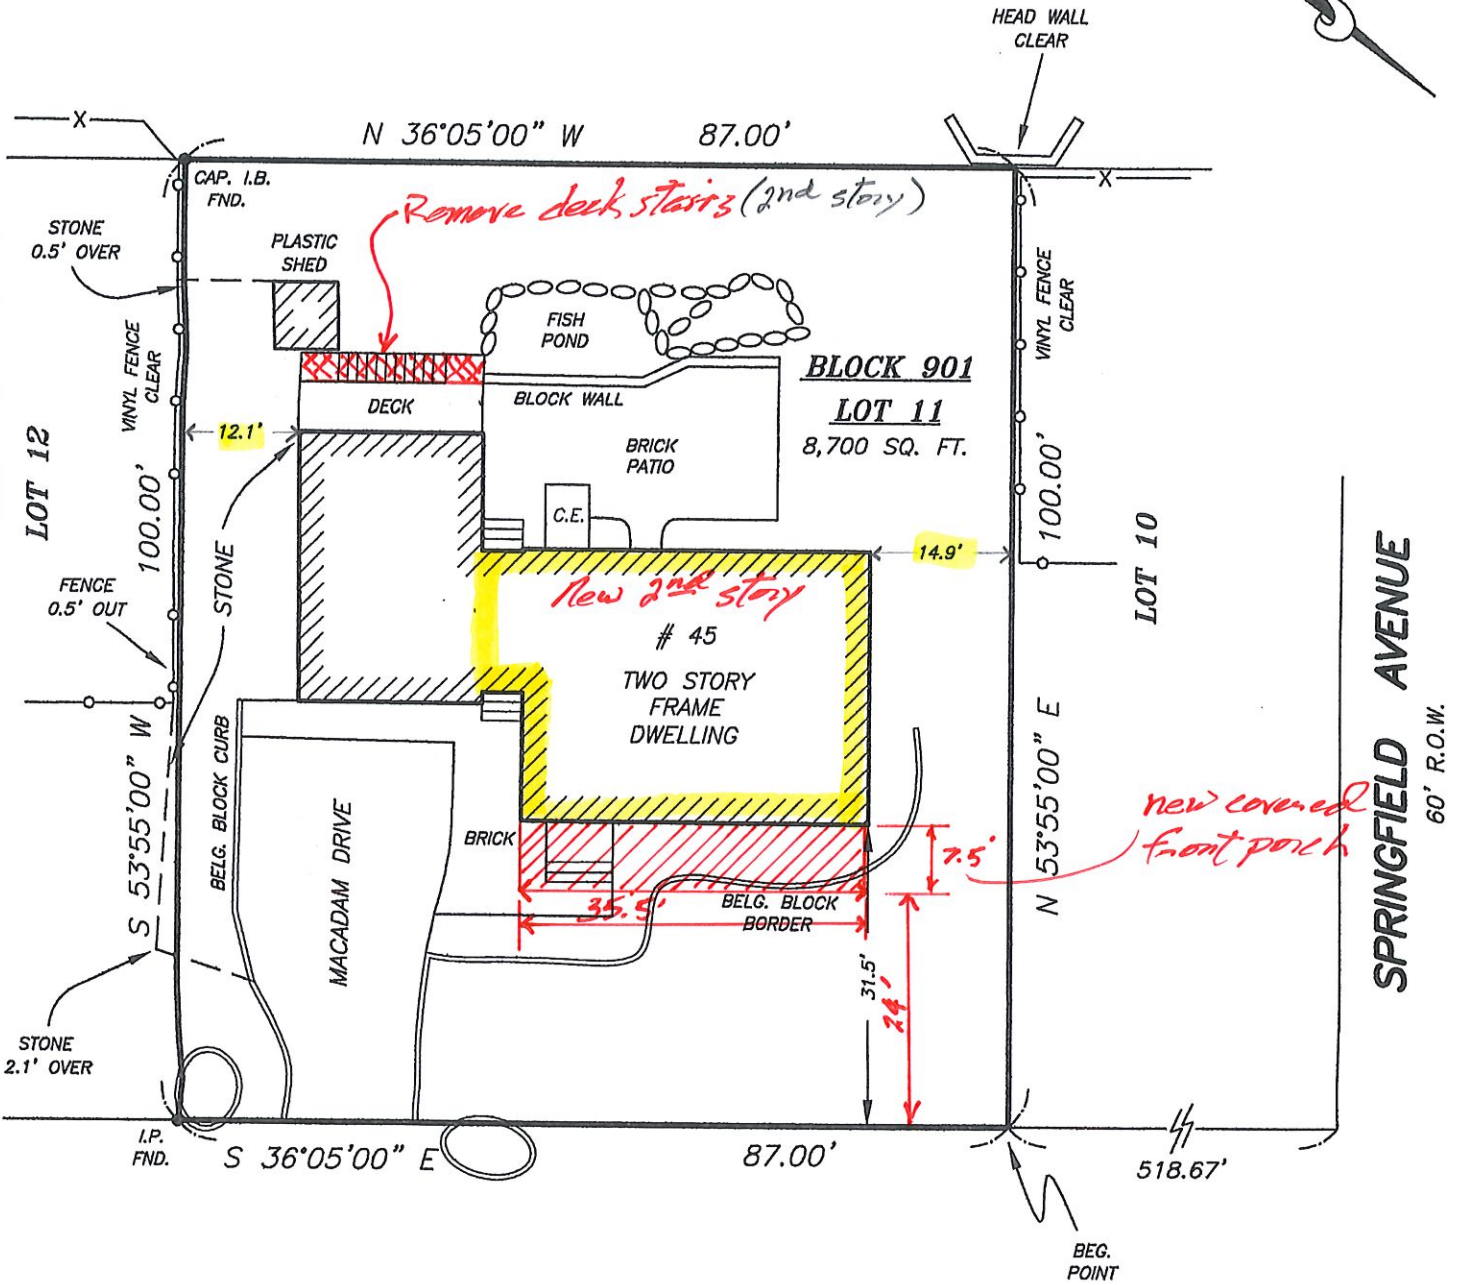


RECEIVED

OCT 20 2021

ZONING OFFICE

LOT 15

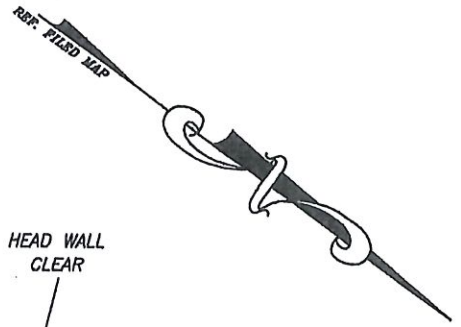

#45 MAPLE AVENUE

50' R.O.W.

THIS SURVEY IS CERTIFIED TO:

- MATTHEW LEMONS

1" = 20' +/-